

AQUARIUM

FLOORS 1, 2, 4
& ROOF

BUILDING 2
1 CIRCLE STAR WAY
San Carlos, CA 94070

ROOF LEVEL PLAN



ISSUE:	DATE:	DESCRIPTION:
-	04/30/13	PROGRESS SET
-	05/22/13	ISSUE FOR PERMIT
△	06/03/13	ADDENDUM B
-	06/24/13	RESPONSE TO PLAN CHECK
-	06/07/13	BULLETIN #1
-	06/13/13	BULLETIN #2
-	06/12/13	BULLETIN #3
-	06/13/13	BULLETIN #4
-	06/13/13	BULLETIN #5
-	06/14/13	BULLETIN #6
-	06/14/13	BULLETIN #7
-	06/14/13	BULLETIN #8
-	06/14/13	BULLETIN #9
△B	06/14/13	BULLETIN #10
-	06/14/13	BULLETIN #11

DRAWN BY: JKAHLON

REVIEWED BY: J. GUNSUL

APPROVED BY: B. TAKAHASHI

DES PROJECT NO.: 9944.001

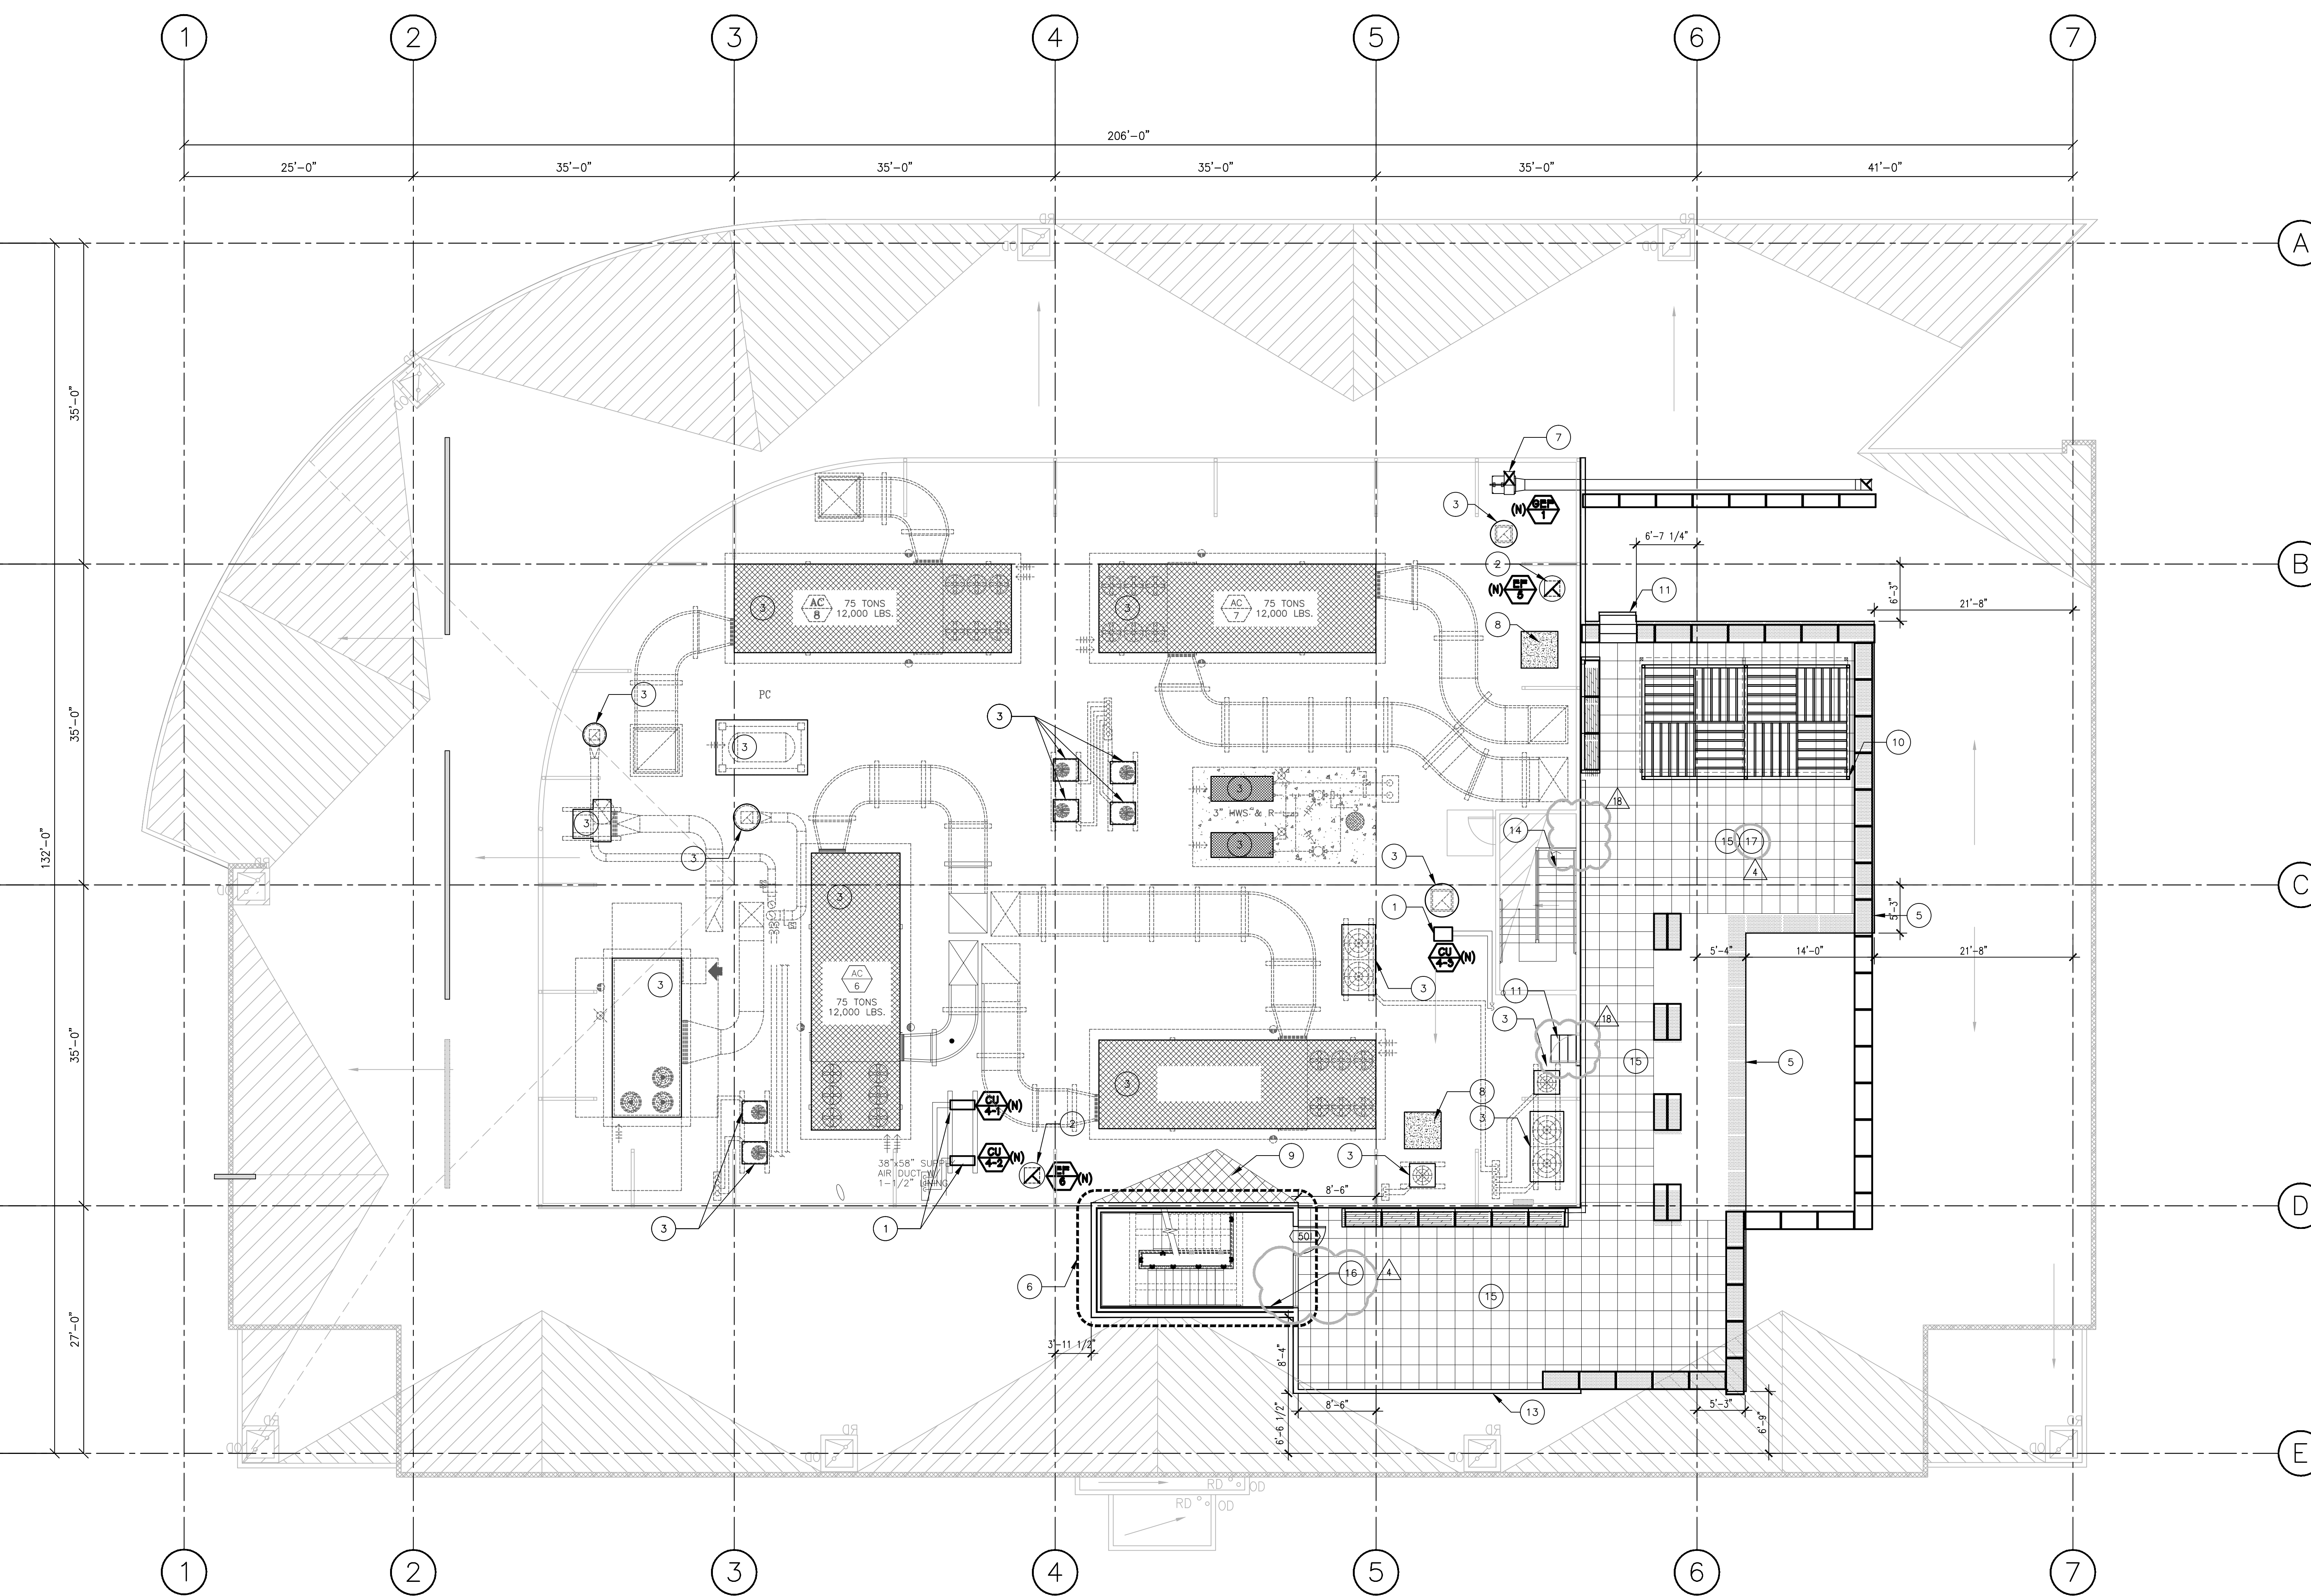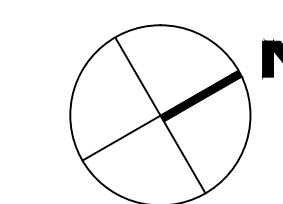


1 ROOF LEVEL PLAN
SCALE: 1/8"=1'-0"

ROOF PLAN NOTES:

- REFER TO A2.01 FOR COMPREHENSIVE FLOOR PLAN GENERAL NOTES.
- STAR PENTHOUSE ROOFING TO BE AS NOTED IN SHEET A8.03. THE RIGID INSULATION SHALL CONSTITUTE AS 3/4" FESCO BOARD OVER POLYISOCYANURATE INSULATION, OR APPROVED EQ. AS REQUIRED FOR A R-19 INSULATION VALUE.
- SEE STRUCTURAL PENTHOUSE FRAMING PLANS FOR STEEL ROOF SLOPES.
- ALL ROOF SLOPES TO BE 1/4" PER FOOT MINIMUM.
- PROVIDE CRICKET AS REQUIRED FOR SLOPE TO DRAIN.
- SEE ELECTRICAL DRAWINGS FOR SPACING AND LOCATION OF PROPOSED LIGHTING FIXTURES TO MEET EXIT LIGHTING REQUIREMENT, LIGHTS TO BE PROVIDED ON THE EXISTING ROOF SCREEN AND THE PERGOLA.
- DEFERRED ITEMS
- NEW STAR DESIGN (DESIGN-BUILD)
- STRUCTURAL VERIFICATION OF ROOFTOP WITH ADDED MECHANICAL UNITS
- DESIGN-BUILD
- SUPPORT FRAMING FOR ROOFTOP PLANTER BOXES
- SUPPORT FRAMING FOR ROOFTOP WATER FOUNTAIN
- NEW ROOF ACCESS STAIR AND ACCESS STAIR FROM NEW ROOFTOP PATIO TO EXISTING ROOF

LEGENDS:

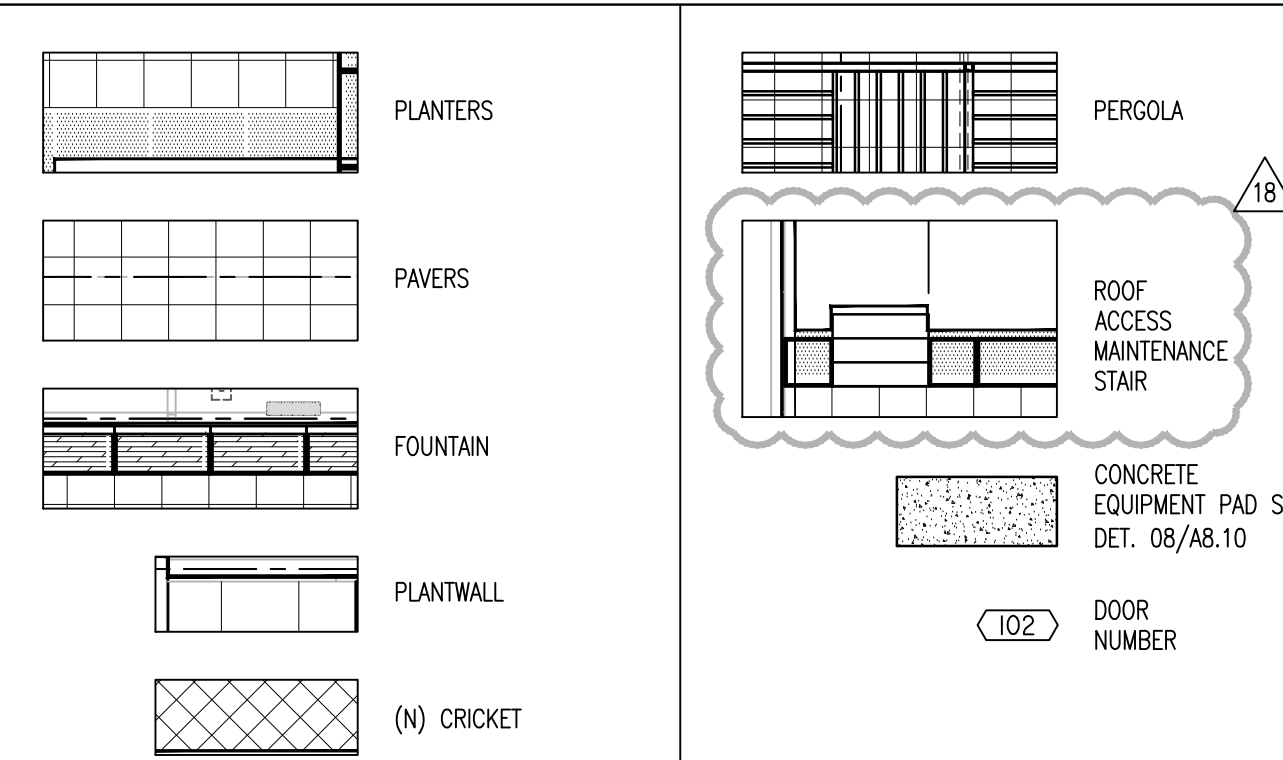

ROOF PLAN KEYNOTES:

- (N) ROOFTOP CONDENSING UNIT ON EXISTING SLEEPERS. REFER TO MECHANICAL DRAWINGS FOR MODEL, WEIGHT, SPECIFICATIONS AND ATTACHMENT DETAILS NOT SHOWN. REFER TO A8.10 FOR FLASHING DETAILS.
- (N) ROOFTOP EXHAUST FAN UNIT. REFER TO MECHANICAL DRAWINGS FOR MODEL, WEIGHT, SPECIFICATIONS AND ATTACHMENT DETAILS NOT SHOWN. REFER TO A8.10 FOR FLASHING DETAILS.
- (E) ROOFTOP UNIT, TO REMAIN
- (E) ROOF SCREEN DOOR, MOVE DOOR TO MATCH SILL OF DOOR TO FLUSH WITH THE PAVERS.
- (N) ROOFTOP GARDEN, REFER TO LANDSCAPE DRAWINGS
- (N) ROOF ACCESS STAIR, REFER TO SHEET A7.01 FOR PLANS & ROOF PLAN
- (N) ROOFTOP GREASE EXHAUST FAN UNIT. REFER TO MECHANICAL DRAWINGS FOR MODEL, WEIGHT, SPECIFICATIONS AND ATTACHMENT DETAILS NOT SHOWN. REFER TO A8.10 FOR FLASHING DETAILS.
- (N) ROOFTOP PADS FOR FOUNTAIN EQUIPMENT, SEE SHEETS L5.02 FOR THE LAYOUT
- (N) CRICKETS INSTALLED FOR DRAINAGE
- (N) PERGOLA, FOR DETAILS SEE SHEET A8.05 AND STRUCTURAL SHEETS.

- (N) ROOF ACCESS STAIR FOR MAINTENANCE
- NOT USED
- (N) ROOF SCREEN - ART WALL, SEE SHEET A8.04, ALUCOBOND TO MATCH (E) ROOF SCREEN
- (E) EXIT STAIR FOR ROOF ACCESS.
- PAVERS IN ROOF GARDEN TO ALIGN W/ T.O. (EX) STAIR LANDING (V.I.F.). ALIGN SURFACES.
- SWITCH FOR LIGHTING AND RUNNING WATER. REFER TO ELECTRICAL DRAWINGS
- ALL (E) DOORS THAT ARE TO HAVE CARD READERS INSTALLED TO BE RETRO-FITTED WITH ELECTRIFIED HARDWARE, BY SECURITY VENDOR

